

Date: Thursday, 1/19/2006 10:43:33 AM
 User: Kim Johnston

Process Sheet

Customer : CU-DAR001 Dart Helicopters Services	Drawing Name : STEP WELDMENT
Job Number : 25555	
Estimate Number : 10744	
P.O. Number : NIA	Part Number : D34633F
This Issue : 1/19/2006 S.O. No. : NIA	Drawing Number : D3463 REV. B
Prsht Rev. : NC	Project Number : N/A
First Issue : 1/18/2006 Type : PURCHASED PARTS	Drawing Revision : B
Previous Run : 24930	Material : NIA
Written By : <u>SEE COMMENT BELOW</u>	Due Date : 1/25/2006 Qty: 1 Um: Each
Checked & Approved By : <u>SEE COMMENT BELOW</u>	
Comment : EST REV: A 05.11.18 NEW ISSUE EC	

Additional Product

Job Number:



Seq. #:	Machine Or Operation:	Description :
---------	-----------------------	---------------

1.0	D34633F	Step Flat Pattern
-----	---------	-------------------



Comment: Qty.: 1.0000 Each(s)/Unit Total : 1.0000 Each(s)
 Step Flat Pattern

2.0	OUTSIDE SERVICE	OUTSIDE SERVICES
-----	-----------------	------------------



Comment: Sub-Contracting OUTSIDE SERVICES
 Issue P/O: _____

Email or Ship DXF file to vendor

Laser Cut per Dwg D3463 flat-pattern D3463-3F

Material release note required

Make as per Dwg D3463

Mat'l 304SS 0.060" thick

FF 06-01-20 batch: 119059

3.0	PACKAGING 1	PACKAGING RESOURCE #1
-----	-------------	-----------------------



Comment: PACKAGING RESOURCE #1

Receive & Inspect For Transit Damage

Ensure material certification is attached

4.0	QC6	DIMENSION
-----	-----	-----------



Comment: DIMENSIONAL CHECK

5.0	SMALL FAB 1	SMALL & MEI
-----	-------------	-------------



Comment: SMALL & MEDIUM FAB RESOURCE 1
 Deburr if necessary.

Bend parts & form the part.

SB 06/01/23

SB 06/01/23

W/O:		WORK ORDER CHANGES					
DATE	STEP	PROCEDURE CHANGE	By	Date	Qty	Approval Chief Eng / Prod Mgr	Approval QC Inspector

Part No: _____ PAR #: _____ Fault Category: _____ NCR: Yes ☒ No ☐ DQA: SD Date: 06/01/24
 QA: N/C Closed: _____ Date: _____

NCR:		WORK ORDER NON-CONFORMANCE (NCR)						
DATE	STEP	Description of NC Section A	Corrective Action Section B			Verification Section C	Approval Chief Eng	Approval QC Inspector
			Initial Chief Eng	Action Description Chief Eng	Sign & Date			

NOTE: Date & initial all entries

Date: Thursday, 1/19/2006 10:43:33 AM
User: Kim Johnston

Process Sheet

Customer: CU-DAR001 Dart Helicopters Services

Drawing Name: STEP WELDMENT

Job Number: 25555

Part Number: D34633F

Job Number:



Seq. #:

Machine Or Operation:

Description :

6.0

QC5

INSPECT WORK TO CURRENT STEP



Comment: INSPECT WORK TO CURRENT STEP

SB 06/01/23

7.0

PACKAGING 1

PACKAGING RESOURCE #1



Comment: PACKAGING RESOURCE #1

Identify and Stock

Location: GA

SB 06/01/23

8.0

DC

DOCUMENT CONTROL



Comment: DOCUMENT CONTROL

Inspection Level 21

SB 06/02/01 (1)

(SB) 06/01/24

Job Completion



W/O:		WORK ORDER CHANGES					
DATE	STEP	PROCEDURE CHANGE	By	Date	Qty	Approval Chief Eng / Prod Mgr	Approval QC Inspector

Part No: _____ PAR #: _____ Fault Category: _____ NCR: Yes No DQA: _____ Date: _____


QA: N/C Closed: _____ Date: _____

NCR:		WORK ORDER NON-CONFORMANCE (NCR)						
DATE	STEP	Description of NC Section A	Corrective Action Section B			Verification Section C	Approval Chief Eng	Approval QC Inspector
			Initial Chief Eng	Action Description Chief Eng	Sign & Date			

NOTE: Date & initial all entries

DART

DESIGN RF	DRAWN BY RF	DART AEROSPACE LTD HAWKESBURY, ONTARIO, CANADA	
CHECKED #	APPROVED #	DRAWING NO. D3463	REV. B SHEET 1 OF 4
DATE 05.12.05		TITLE STEP WELDMENT	SCALE 1:8
A	05.09.20	NEW ISSUE	
B	05.12.05	REVISE DIM.; D3463-5 WAS D3463-5F	

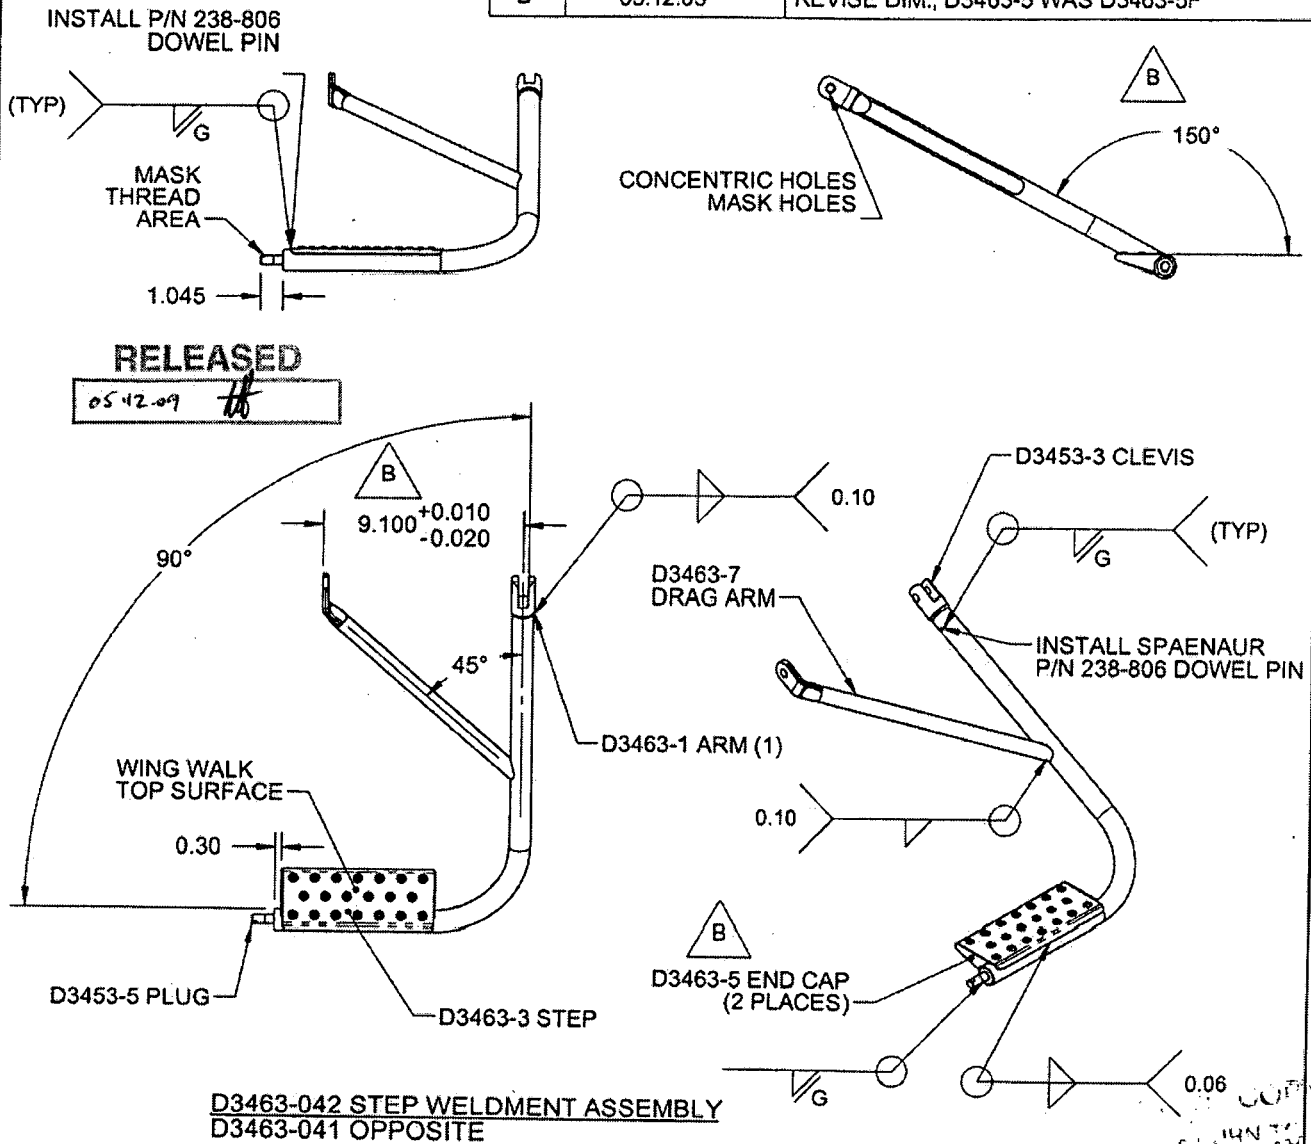**NOTES:**

- 1) WELD PER DART QSI 004
- 2) FINISH: POWDER COAT WHITE (4.3.5.2) PER DART QSI 005 4.3
BLACK ANTI-SKID PAINT PER DART QSI 005 4.4
- 3) TOLERANCES ARE PER DART QSI 018 UNLESS OTHERWISE NOTED
- 4) ALL DIMENSIONS ARE IN INCHES
- 5) BREAK ALL UNMARKED SHARP EDGES 0.005 TO 0.010
- 6) IDENTIFY WITH DART P/N USING FINE POINT PERMANENT INK MARKER


COPYRIGHT © 2005 BY DART AEROSPACE LTD.

THIS DOCUMENT IS PRIVATE AND CONFIDENTIAL AND IS SUPPLIED ON THE EXPRESS CONDITION THAT IT IS NOT TO BE USED FOR ANY PURPOSE OR COPIED OR COMMUNICATED TO ANY OTHER PERSON WITHOUT WRITTEN PERMISSION FROM DART AEROSPACE LTD.

CONTROLLED COPY
NOT TO AMENDMENT
WITHOUT NOTICE
WORK ORDER
NO. 25535

DART

DESIGN RF	DRAWN BY RF	DART AEROSPACE LTD HAWKESBURY, ONTARIO, CANADA	
CHECKED <i>[Signature]</i>	APPROVED <i>[Signature]</i>	DRAWING NO. D3463	REV. B SHEET 2 OF 4
DATE 05.12.05	TITLE STEP WELDMENT		SCALE 1:4

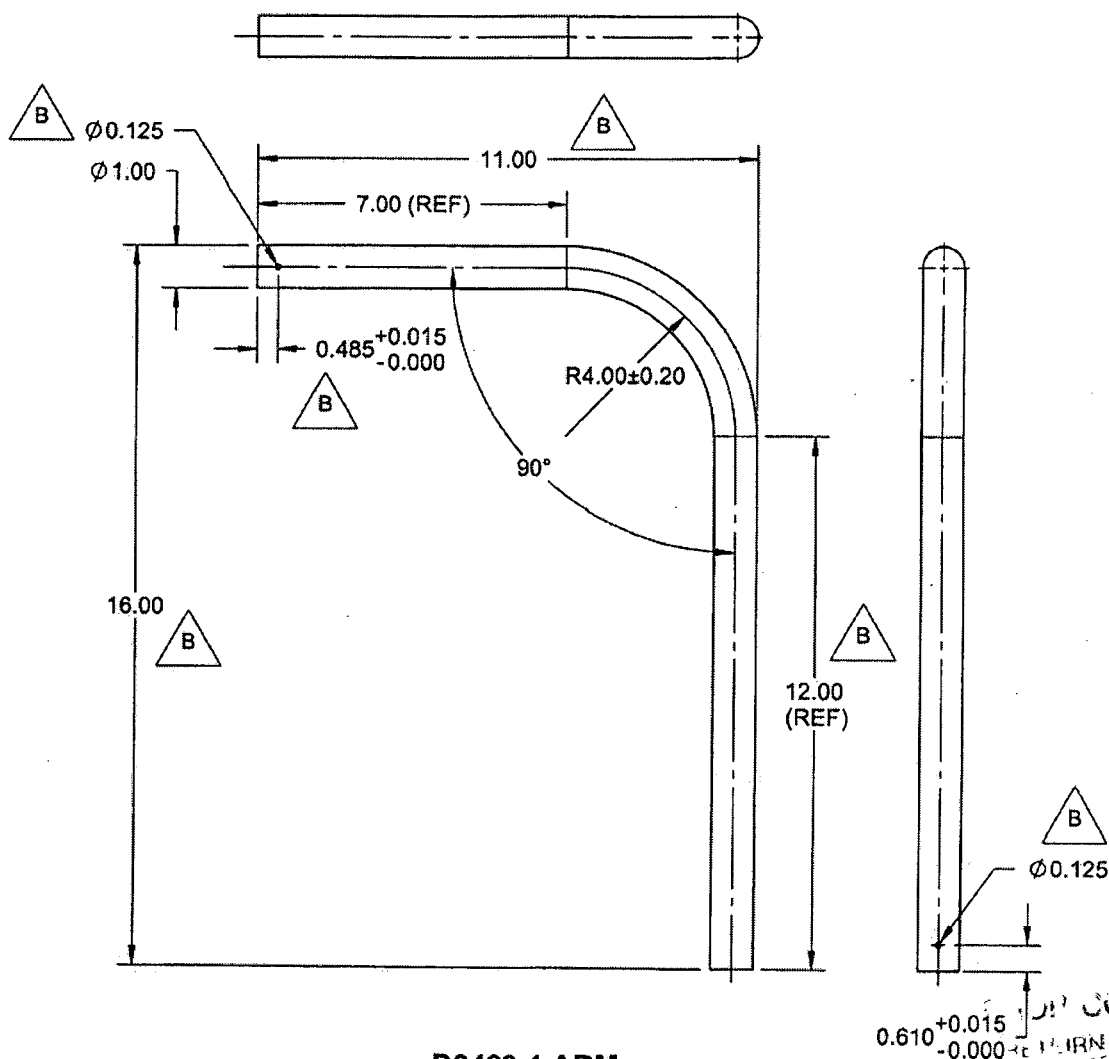RELEASED05.12.09 *[Signature]***D3463-1 ARM****NOTES:**

- 1) MATERIAL: AISI 316/304 SS SEAMLESS TUBING (REF. DART SPEC. M304TR1.000W.120)
- 2) FINISH: NONE
- 3) TOLERANCES ARE PER DART QSI 018 UNLESS OTHERWISE NOTED
- 4) ALL DIMENSIONS ARE IN INCHES
- 5) BREAK ALL UNMARKED SHARP EDGES 0.005 TO 0.025

COPYRIGHT © 2005 BY DART AEROSPACE LTD.

THIS DOCUMENT IS PRIVATE AND CONFIDENTIAL AND IS SUPPLIED ON THE EXPRESS CONDITION THAT IT IS NOT TO BE USED FOR ANY PURPOSE OR COPIED OR COMMUNICATED TO ANY OTHER PERSON WITHOUT WRITTEN PERMISSION FROM DART AEROSPACE LTD.


0.610+0.015/-0.000
UNCONTROLLED COPY
RETURN TO
ENGINEERING
FOR AMENDMENT
NOTICE
WORK ORDER
25355




DESIGN RF	DRAWN BY RF	DART AEROSPACE LTD HAWKESBURY, ONTARIO, CANADA	
CHECKED #	APPROVED #	DRAWING NO. D3463	REV. B SHEET 4 OF 4
DATE 05.12.05	TITLE STEP WELDMENT		SCALE 1:2

RELEASED


05.12.05 #

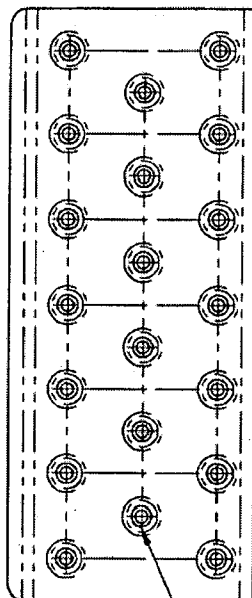


FORM USING
D3463-3T1

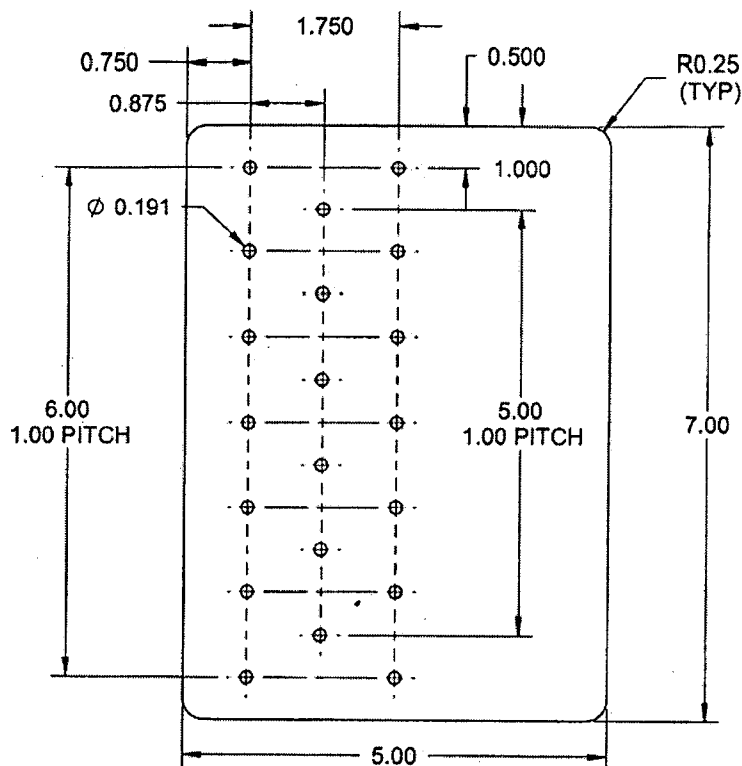

D3463-3F FLAT PATTERN

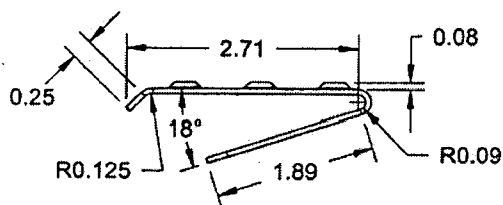

D3463-3 STEP

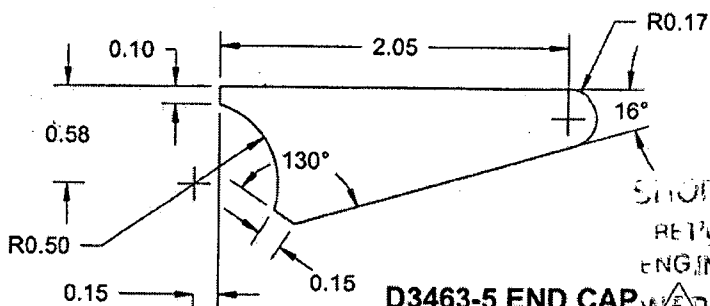

D3463-5 END CAP
SCALE 1:1

NOTES:

- 1) MATERIAL: AISI 304/316 SS SHEET, 0.060 THICK (REF. DART SPEC. M304S16GA)
- 2) FINISH: NONE
- 3) TOLERANCES ARE PER DART QSI 018 UNLESS OTHERWISE NOTED
- 4) ALL DIMENSIONS ARE IN INCHES
- 5) BREAK ALL UNMARKED SHARP EDGES 0.005 TO 0.010

STOP COPY
RETURN TO
ENGINEERING

NO BROILED COPY
NOT TO BE
WITHOUT

WORK ORDER

NO 25355

COPYRIGHT © 2005 BY DART AEROSPACE LTD.

THIS DOCUMENT IS PRIVATE AND CONFIDENTIAL AND IS SUPPLIED ON THE EXPRESS CONDITION THAT IT IS NOT TO BE USED FOR ANY PURPOSE OR COPIED OR COMMUNICATED TO ANY OTHER PERSON WITHOUT WRITTEN PERMISSION FROM DART AEROSPACE LTD.